



# UPSHUR COUNTY COMMISSIONERS COURT

GILMER, TEXAS

June 10, 1968

Commissioners Court of Upshur County met in regular session with all members present. Motion was made and seconded to allow Arkansas-Louisiana Gas Company to re-locate one 4 inch pipeline, referred to as Line F-370 in application, across county roads in agreement with terms and map attached to these minutes. Motion carried.

*L. G. McKinley*

*Dwight Holmes*  
*W. L. Langford*  
*A. D. Hackler*



## ARKANSAS LOUISIANA GAS COMPANY

P O BOX 1734 • SHREVEPORT, LOUISIANA • 71102

June 10, 1968

Honorable L. G. McKinley  
County Judge, Upshur County  
Gilmer, Texas

Re Line F-370

Dear Sir,

As per our telephone conversation of June 7, 1968, please find enclosed our corrected application which now includes the clause as to any future relocation of the gas line at the company's expense

Thank you for your cooperation.

Very truly yours,

ARKANSAS LOUISIANA GAS COMPANY

*Albert A. Walker, Jr.*  
Albert A. Walker, Jr.

AAW, Jr/jo  
Enc.

R/W No \_\_\_\_\_

STATE OF TEXAS )  
                  )  
COUNTY OF UPSHUR )

Line F-370

TO THE HONORABLE COUNTY COURT OF SAID COUNTY OF UPSHUR,  
STATE OF TEXAS

Your Petitioner, ARKANSAS LOUISIANA GAS COMPANY, a Delaware Corporation, having a permit to do business in the State of Texas, and with its principal office in Shreveport, Louisiana, respectfully represents that it is now engaged in the sale and transportation of natural gas, and has the authority to construct pipelines for transporting such gas through pipelines, and that it desires to construct the following facilities at the location described

- (1) A four-inch gas pipe line crossing two (2) County Roads in Clarence Hardeman 50 acre tract (Aniseta Lumbrera Survey) and in M R Ferguson 14 8 acre tract (C B Powell Survey) as shown in red on attached plats

and that in the construction of the said gas pipeline, it will be necessary to lay its pipeline, in and across County Roads in Upshur County, Texas, at the locations shown on the plat attached hereto and made a part hereof

Your Petitioner understands and accepts the condition that in the event the County authorities find it necessary to enlarge, widen, straighten or otherwise improve these roads, then in that event the Gas Company will relocate such lines as required by the County at the expense of the Gas Company


Your Petitioner, therefore prays for permission to construct and maintain its gas line in and under the public roads now under the jurisdiction of the County Court of Upshur County at the locations shown on the maps attached hereto, and that an order be entered by this Court granting such permission

Respectfully submitted,

ARKANSAS LOUISIANA GAS COMPANY

By J. G. Cooke, Jr.  
J. G. Cooke, Jr.  
Manager, Land Department

292

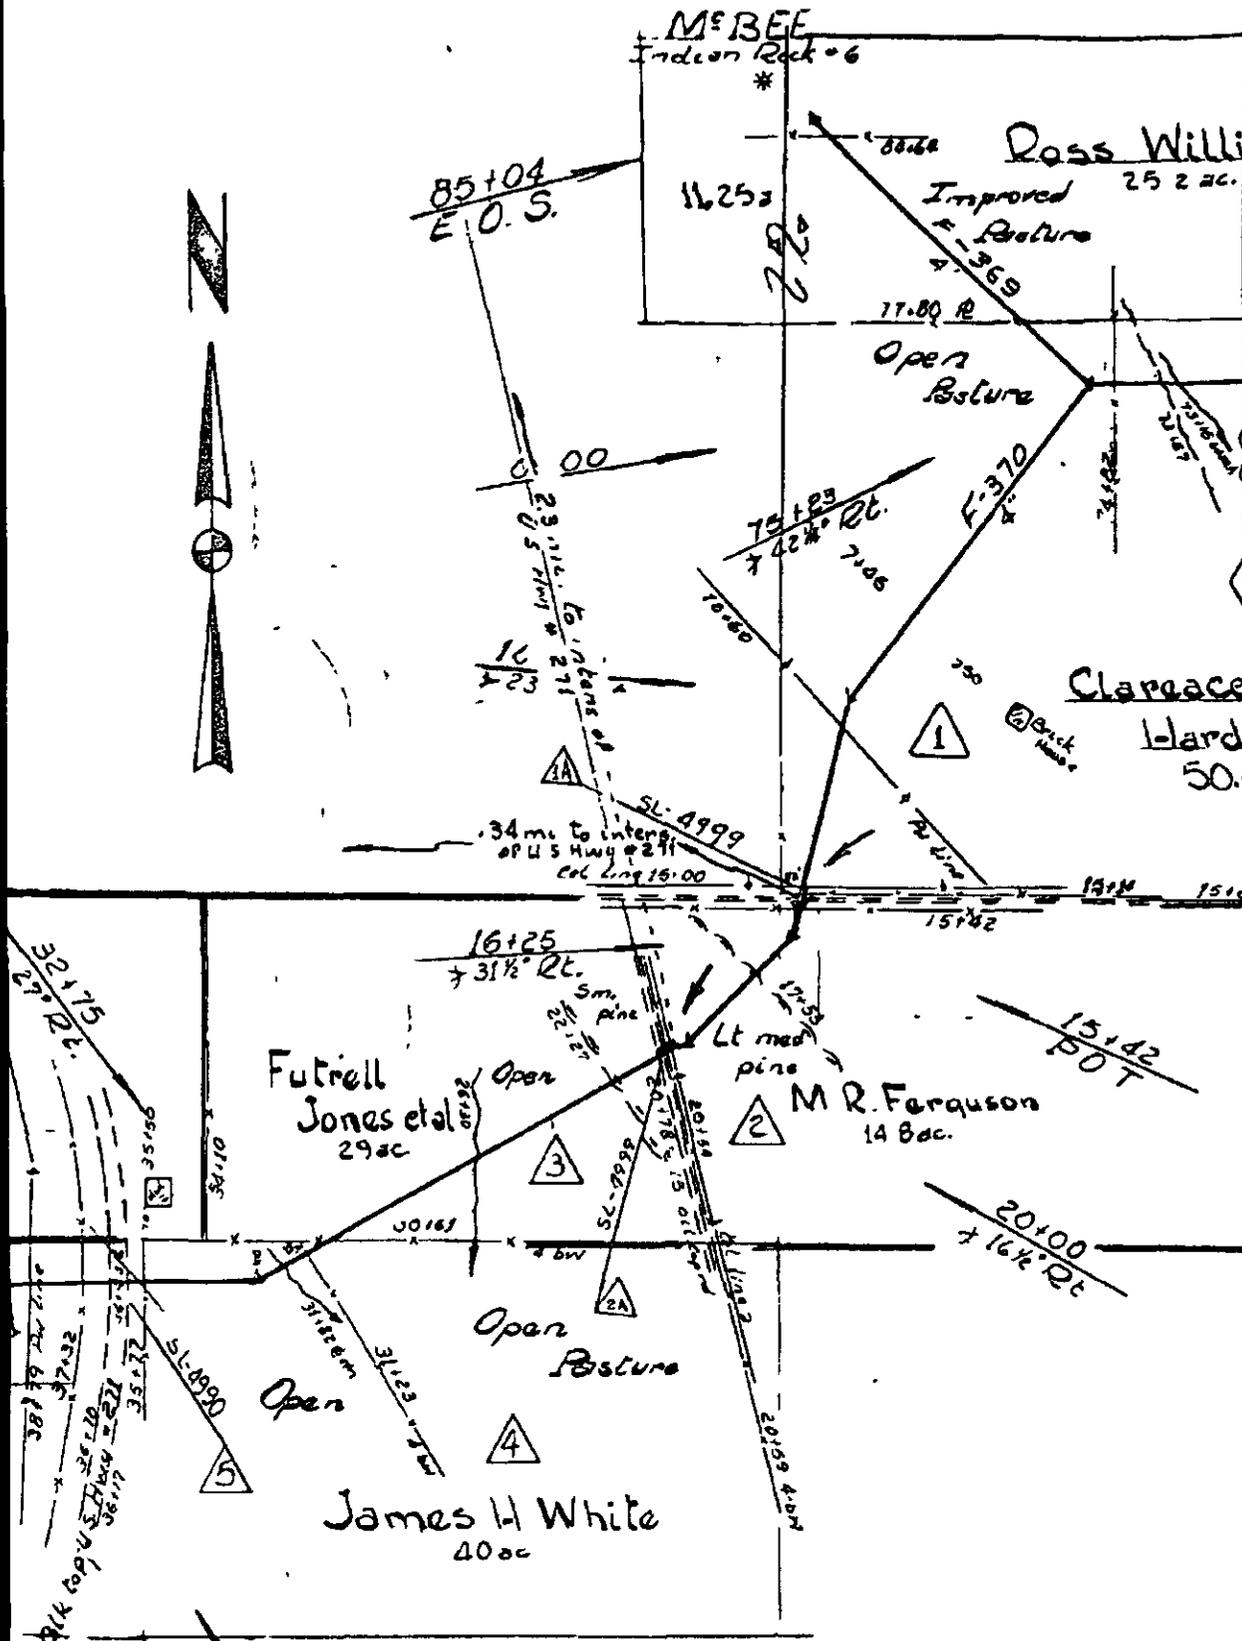

MALINDA THORNTON  
A-485.

ARKANSAS LOUISIANA GAS COMPANY  
Plat Showing  
Proposed 4" gas pipeline P-370  
crossing 2 County Rds. in Clarence  
Hardeman 50 ac. tract (Aniseta  
Lumbrera A-3 Sur.) & in M. R.  
Ferguson 14.8 ac. tract (C. B.  
Powell Sur.) in Upshur County,  
Texas.

Sur. by W. L. N. Date: 4-15-68  
Bk. 1171 Pg. 4-11 Scale: 1"=400'