

75 10 1:20

November 3, 1975

The Commissioners Court met in regular session with all members present: Offie Nobles, Charles Still, J. W. Meadows, Floyd Drennan and Judge Everett Dean. Judge Dean Presided.

The Veterans of Foreign Wars with drew their application to meet in the Courthouse for their meeting place.

A letter from the Texas Justice of Peace Training Center was read stating that four Justice of Peace from Upshur County had completed a 20 hour course teaching the responsibilities of a Justice of Peace. They were as follows: E. S. Simpson, Cyril Bennett, Gorman Coston and H. S. Taff. This school of training was held from October 14th. through 17th., 1975 at Southwestern Texas University, San Marcus, Texas.

A report was made stating that Mrs. A. McKinsey would be unable to serve on the Upshur County Welfare Board. Charles Still made motion for Roy Snow to be appointed to replace Mrs. Ann McKinsey to serve on this Board and a second was made by J. W. Meadows. Motion carried.

E. J. Dreaden of Big Sandy, Texas made a permit application for a waterline and Culvert to be placed on the right-of-way of Highway 80 in Upshur County. Charles Still made motion to approve this Application and was seconded by Floyd Drennan. Motion carried.

A permit Application was made from Arkansas Louisiana Gas Company to bore a 2 inch Gas Main Crossing the Upshur County Landing Road. J. W. Meadows made a motion to approve this application and was seconded by Offie Noble. Motion carried. (application attached)

A Permit Application was made form Wil-Mac Oil Company to use a County maintained road to get to a Location to drill for Oil & Gas Charles Still Made motion to approve this permit and was seconded by Floyd Drennan. Motion Carried. (application attached)

J. B. Hill, Jr. County Clerk made a request to go to Austin on Monday November 10, 1975 to attend a Committee Meeting on Elections.

J. W. Meadows made motion to give him permission to attend this meeting and a second was made by Floyd Drennan. Motion carried.

J. W. Meadows made motion to pay bills. Floyd Drennan seconded the motion. Motion carried.

Charles Still Made motion for the meeting to adjourn and a second was made by Floyd Drennan. Motion carried. Court adjourned.

Everett Dean
Offie Nobles

J. W. Meadows
Charles Still
Floyd Drennan

VOL. 17 PG. 176

PERMIT APPLICATION FOR
USE OF UPSHUR COUNTY RIGHT OF WAY

Date 10/17/95

TO: THE UPSHUR COUNTY COMMISSIONERS COURT
COUNTY OF UPSHUR
GILMER, TEXAS

Formal notice is hereby given that F. J. Dreader
whose principal address is Box 1133
does propose to place a Big Sandy, Tx. 75751
within the ROW of County Road Old H/W 80

as follows: water line + Culvert
To Culvert to house.

The location and description of the proposed lines or appertenances
is more fully shown by three (3) copies of drawings attached to
this application.

All work will be as directed by the County Commissioner or his
designate in full accordance with Upshur County Road & Bridge
Department policies and specifications.

Proposed construction will begin, if approved, on or after

_____ day of _____ 19____

Firm: F. J. Dreader, Inc.

Title: _____

Address: _____

THE UPSHUR COUNTY COMMISSIONERS COURT
BOX 39
GILMER, TEXAS 75644

Formal notice is hereby given and request made that Arkansas
Louisiana Gas Company proposes to place Base
2' Gas Main ^{Crossing} within the
right-of-way of County Road Upshur Landing Rd. as follows:

(DESCRIBE AND ATTACH PLAT)

The location and description of the proposed construction and appurtenances is more fully shown by the attached drawing and plat. The line will be constructed and maintained on the county right-of-way as directed by the County Commissioners Court in accordance with current Upshur County specifications.

It is expressly understood that the Upshur County Commissioners Court does not purport, hereby, to grant any right, claim, title, or easement in or upon this county road. It is further understood that in the future, should for any reason, Upshur County need to work, improve, relocate, widen, increase; add to, or in manner change the structure of this right-of-way, this line, if affected, will be moved under the direction of the Upshur County Commissioners and shall be relocated at the complete expense of the owner.

It is further understood and agreed that Upshur County assumes no liability for damages to any line, pole, construction, or appurtenances in the normal maintenance of the county road.

All work on the county right-of-way shall be performed in accordance with the County Commissioner's instructions. The installation shall not damage any part of the highway and adequate provisions must be made to cause minimum inconvenience to traffic and adjacent owners.

With the approval of the Commissioners Court construction will begin on or after 20th day of October 1975

FIRM ARKLA Gas Co
BY Don Hartzell
District Manager
Title
Box 859
Address
Gilmer, Texas
J.W. Meadows
C. J. Hall
Thayer L. Swann

APPROVED: Ernest Adams
E. P. ...

(This form to be submitted in duplicate for each proposed installation.)

ARKANSAS-LOUISIANA GAS COMPANY

VOL. 17 PG. 178

ENGINEERING DIAGRAM


J. O. NO. 116 W. O. NO. _____ COUNTY Logan PARISH _____ STATE Texas

PIPE LAID OR REMOVED

SIZE	STEEL, C I, PLASTIC	HOW COUPLED	AMOUNT	WEIGHT PER FOOT	WALL THK	GRADE	NEW OR #2	COATING	MANUFACTURER	OTHER
	<u>Iron</u>	<u>W/I/I</u>	<u>15'</u>	<u>11</u>	<u>1.0"</u>	<u>F</u>	<u>N.</u>	<u>1 coat</u>	<u>P.T.</u>	

FITTINGS AND OTHER MATERIAL	<u>1-11" x 1/2" R</u>
	<u>1-11" x 1/2" R</u>
	<u>1-11" x 1/2" R</u>

WORK COMPLETED 1-1-1925 INV MAP RF 257 SERVICE MAP No. 2 STREET W. 1st St. Waco, Tex.
 FOREMAN L. W. Hunt TOWN RF 257 PLAT Waco, Texas

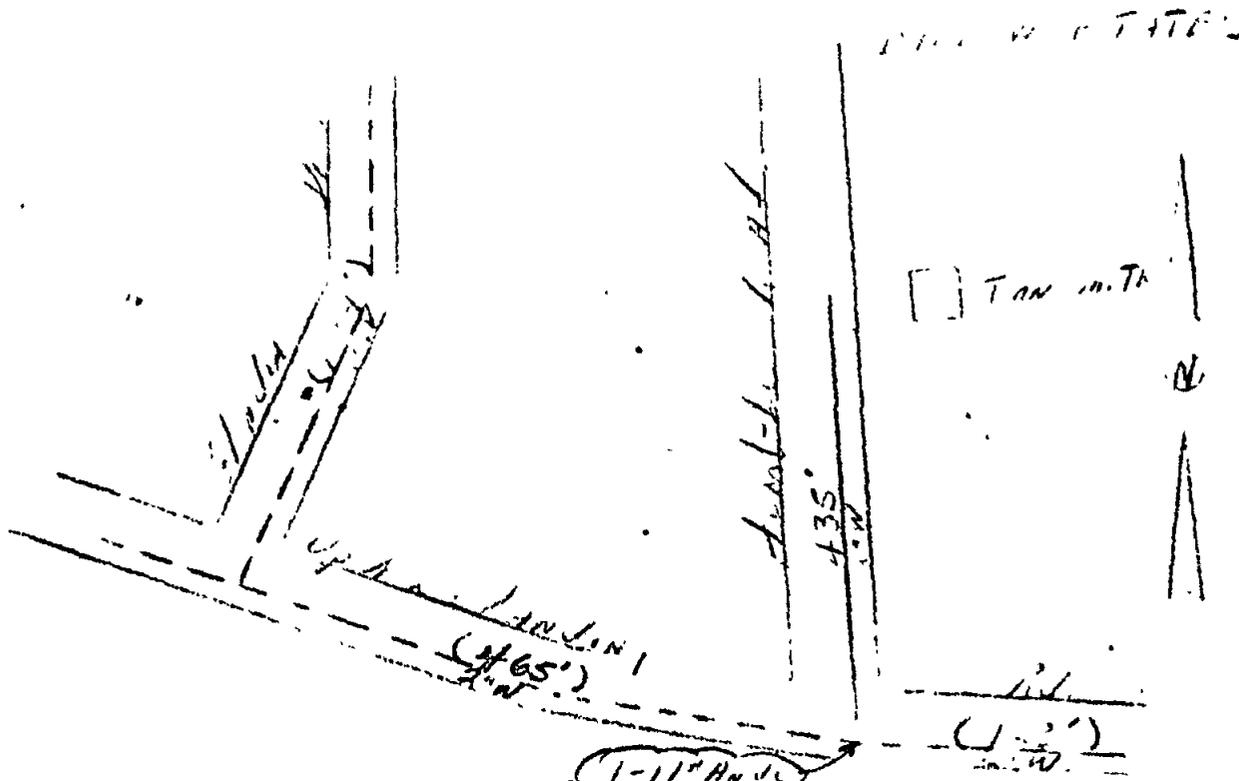

BELOW FOR USE OF ENGINEERING DEPARTMENT

C. P.: STA.: ETC.	LAID	REMOVED	INV. MAP
SIZE			

DIAG. NO. _____ CHECKED _____ POSTED AT _____
 { S P O R T _____ BY _____
 _____ BY _____

PERMIT APPLICATION FOR
USE OF UPSHUR COUNTY RIGHT OF WAY

Date October 20, 1975

TO: THE UPSHUR COUNTY COMMISSIONERS COURT
COUNTY OF UPSHUR
GILMER, TEXAS

Formal notice is hereby given that The Wil-Mc Oil Corp.
whose principal address is 3005 Fidelity Union Tower Bldg. Dallas, Tex. 75201
does propose to ~~#####~~ drill for oil or gas at a location as shown on the attached plats.

~~#####~~ A county maintained road is to be used to get to the location. A sketch of the
~~#####~~ road is on the location plat attached.

as follows:


See plat.

The location and description of the proposed lines or appertenances
is more fully shown by ~~three~~ ^{two} (2) copies of drawings attached to
this application.

All work will be as directed by the County Commissioner or his
designate in full accordance with Upshur County Road & Bridge
Department policies and specifications.

Proposed ~~construction~~ ^{drilling} will begin, if approved, on or after
1 day of November 19 75

Firm: The Wil-Mc Oil Corp.
Title: *Edward E. ...*
Wil-Mc Oil Corp.
Address: 3005 Fidelity Union Tower Bldg.
Dallas, Texas 75201

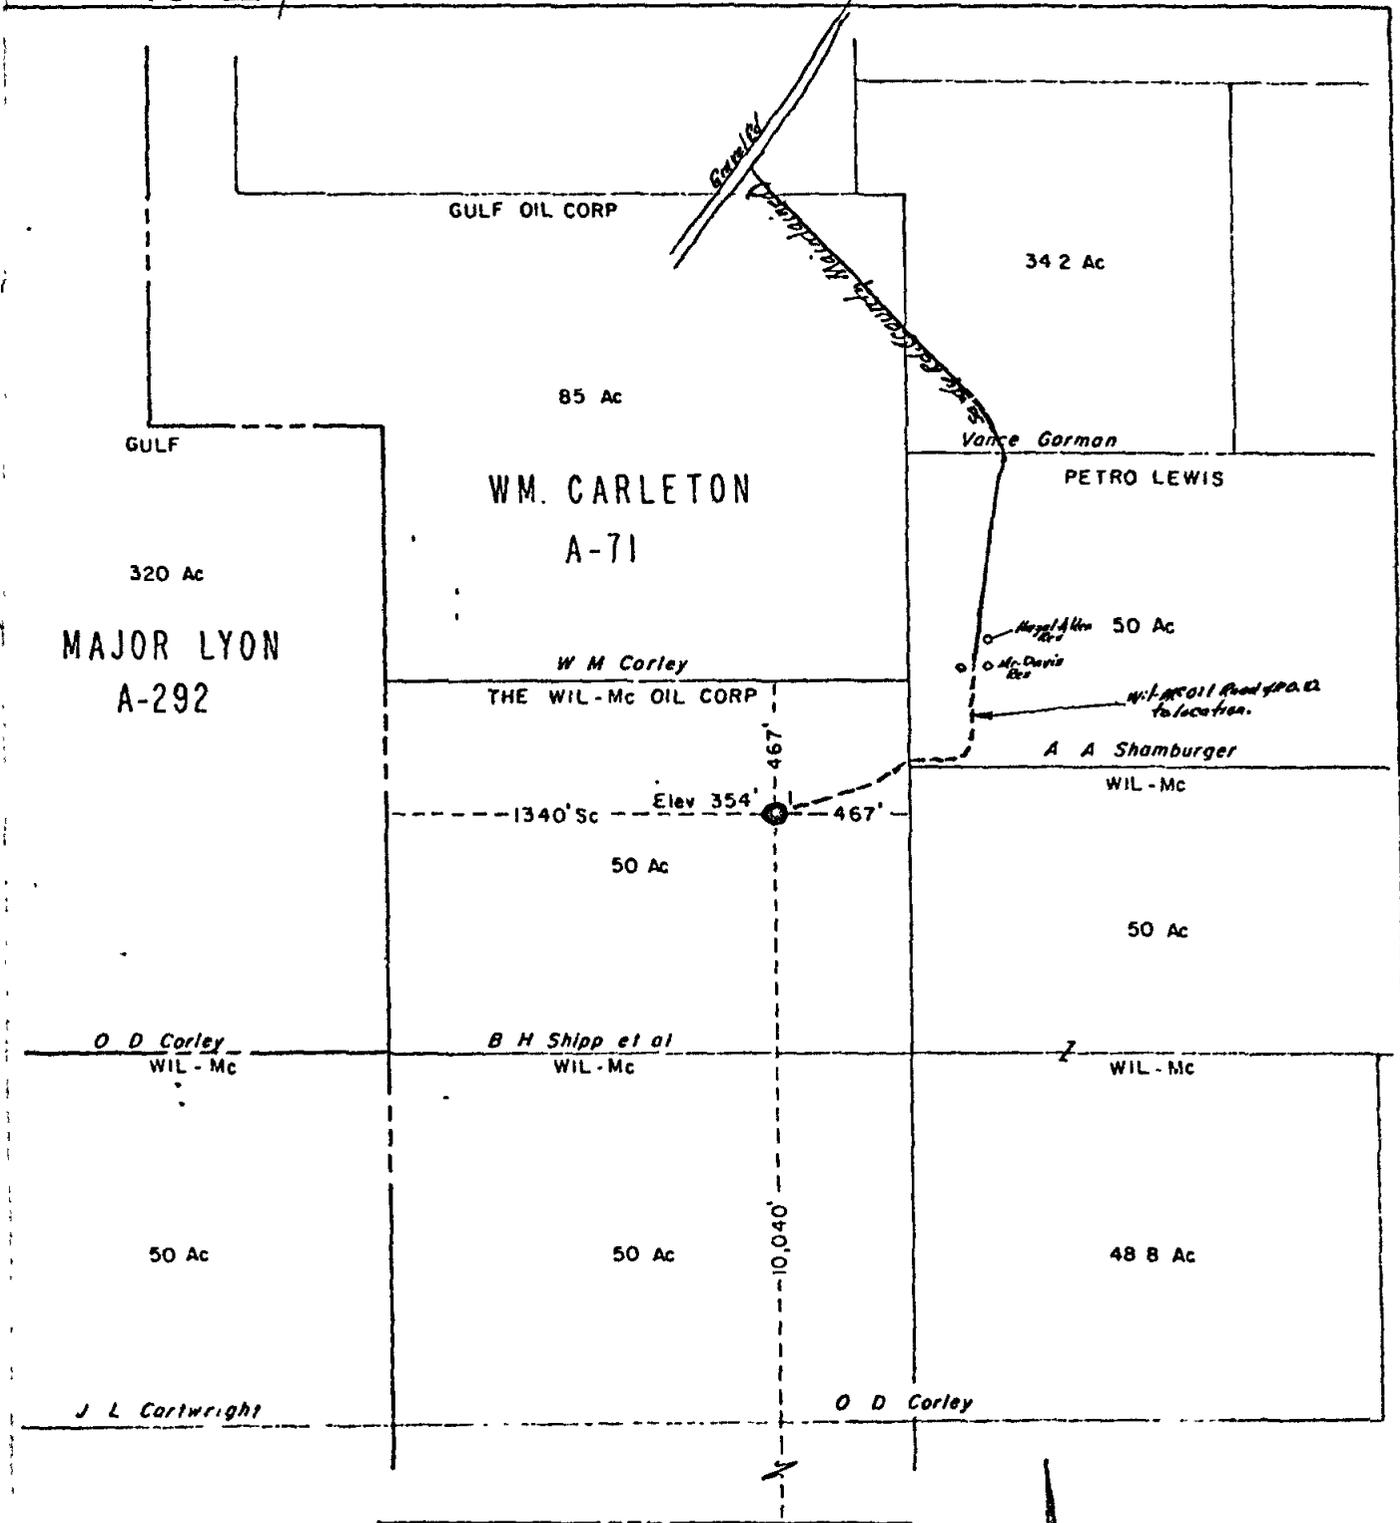



STATE OF TEXAS
COUNTY OF SMITH

I, Harry L. Johnson, Registered Public Surveyor, do hereby certify that the above plat is true and correct to the best of my knowledge

Date Oct. 9, 1975 Tyler, Texas

Harry L. Johnson
Registered Public Surveyor
State of Texas No. 62

WELL LOCATION PLAT
THE WIL-Mc OIL CORP
"B H SHIPP ET AL" NO 1 WELL
WM CARLETON SURVEY
PSHUR CO, TEXAS
SCALE 1" = 600'

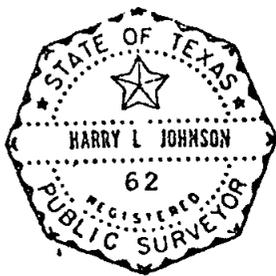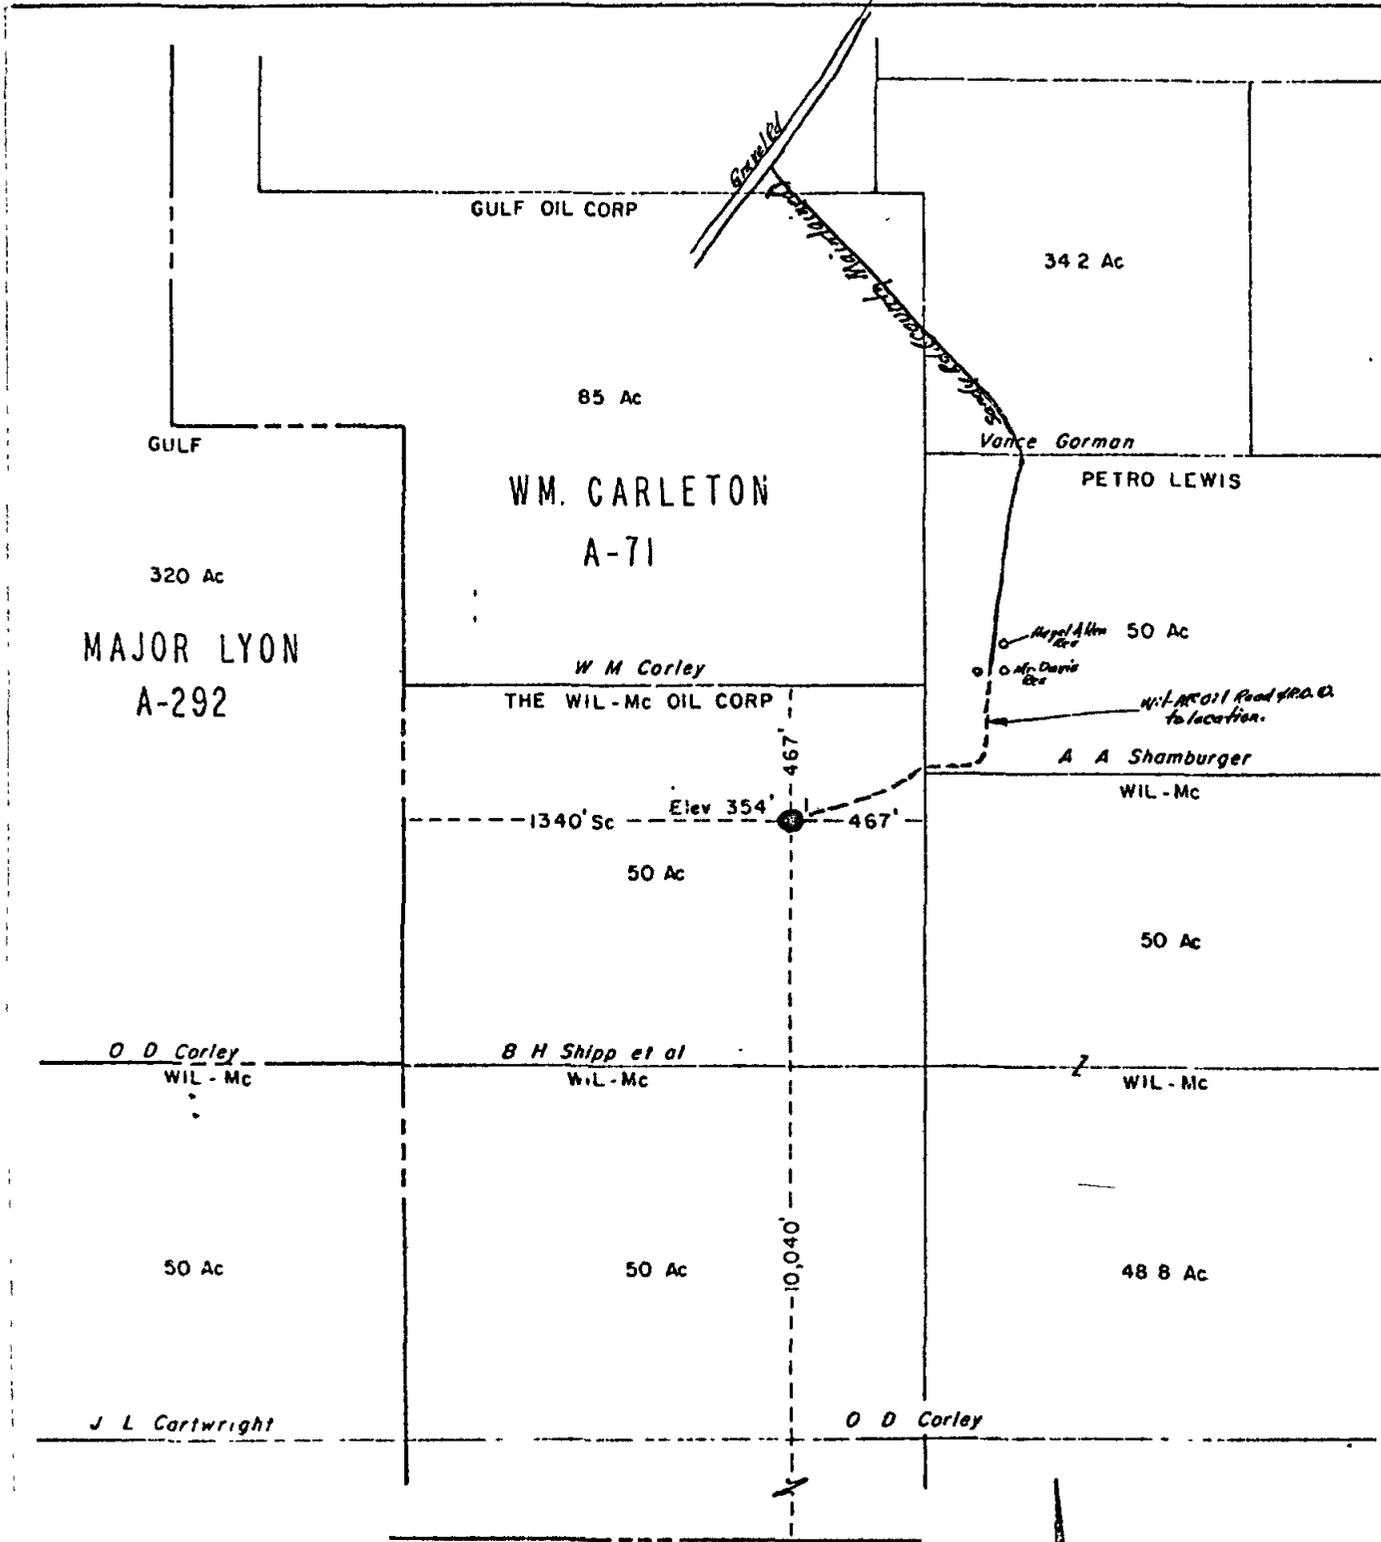

WELL LOCATION PLAT
THE WIL-Mc OIL CORP
"B H SHIPP ET AL" NO 1 WELL
WM. CARLETON SURVEY
SMITH CO., TEXAS
SCALE 1" = 600'

STATE OF TEXAS
COUNTY OF SMITH

I, Harry L. Johnson, Registered Public Surveyor, do hereby certify that the above plat is true and correct to the best of my knowledge

Date Oct. 9, 1975 Tyler, Texas

Harry L. Johnson
Registered Public Surveyor
State of Texas No. 62

VOL. 17 PG. 182

PERMIT APPLICATION FOR
USE OF UPSHUR COUNTY RIGHT OF WAY

Date 10-21-75

TO: THE UPSHUR COUNTY COMMISSIONERS COURT
COUNTY OF UPSHUR
GILMER, TEXAS

Formal notice is hereby given that Robert Bradley
whose principal address is Rt 3 Box 5 lot 19
does propose to place a Driveway Culvert
within the ROW of County Road Pine Oak Road (Pritchett)
as follows:

The location and description of the proposed lines or appertenances
is more fully shown by three (3) copies of drawings attached to
this application.

All work will be as directed by the County Commissioner or his
designate in full accordance with Upshur County Road & Bridge
Department policies and specifications.

Proposed construction will begin, if approved, on or after
_____ day of _____ 19__

Firm: Robert Bradley
Title: _____
Address: Gilmer, Tex.
